


- (A) 3/4"LOOP INSERT FOR 3/4"- 10 ROD.
- B 3/4" IO GALVANIZED MACHINE ROD
- © 1/2" X 2" X 195/8" P.V.C. FLAT BAR.
- \bigcirc I"X 4 $\frac{1}{8}$ "P.V.C. SPACER TUBE.
- E) 2"X 2"X 23%"GALVANIZED SQUARE TUBE.
- F %"STRAND CLAMP ASSEMBLY
- © ¾4" 10 Ø X 10"GALVANIZED THREADED ROD.
- H 3/4" NUTS, WASHERS, AND LOCK WASHERS.
 12" HIGH X 24" WIDE OPENING REQUIRED THROUGH END WALLS
 12" HIGH X 24" WIDE OPENING REQUIRED THROUGH DIAPHRAGMS.

DETAIL OF HANGER FOR AT&T CONDUIT

NOTE: PLACE HANGER ATTACHMENTS AT INTERVALS OF UP TO 15 FT.

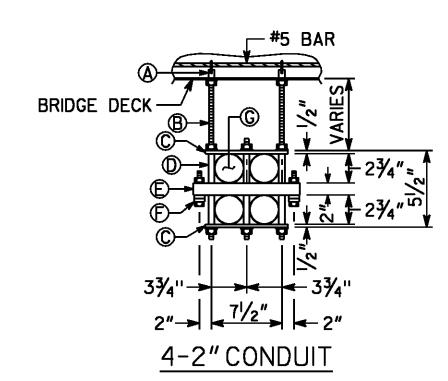


- B 3/4" 10 GALVANIZED MACHINE ROD
- © 1/2" X 2" X 91/2" P.V.C. FLAT BAR.
- © /2 × 2 × 3/2 | IVICITENT DA
- © 1/4" X 2" X 2" X 131/2" FIBERGLASS TUBE.
- (E) STRAND CLAMP
- © 2"Ø FIBERGLASS CONDUIT

DETAIL OF HANGER
FOR GDOT ATMS

NOTE: PLACE HANGER ATTACHMENTS AT INTERVALS OF UP TO 15 FT.

USE ANVIL C.B. UNIVERSAL CONCRETE INSERT FIG. 282, AAA TECHNOLOGY & SPECIALTIES CO., INC. FIGURE 912, OR APPROVED EQUAL. HANGER ASSEMBLIES SHALL BE FURNISHED AND INSTALLED BY GAS COMPANY. INSERTS SHALL BE FURNISHED AND INSTALLED BY CONTRACTOR. HANGERS SHALL BE SPACED AT A MAXIMUM OF 25'-0" O.C.

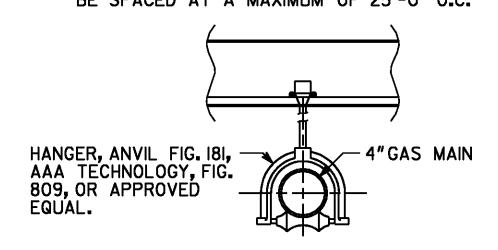

GAS MAIN SUPPORT DETAILS


FENCE NOTES:

I. FENCE SHALL BE 9 GAGE CHAIN LINK ZINC COATED TWO INCH SECURITY FENCE.

2. CAST 4" DIA. GALVANIZED SLEEVE IN THE PARAPET. ALLOW NON-SHRINK GROUT TO CURE FOR THREE DAYS BEFORE FENCE FABRIC IS INSTALLED.

3. APPLY GALVANIZING REPAIR COMPOUND, IN ACCORDANCE WITH GEORGIA DOT SPECIFICATION 645, TO ENDS OF 4" DIA. GALVANIZED SLEEVES.

- 4. PROVIDE EXPANSION SLEEVE FOR ALL RAILS TO MATCH SUPERSTRUCTURE JOINTS.
- 5. FOR POST SPACING, SEE BRIDGE SHEET 35-04.
- 6. FOR FURTHER DETAILS, SEE GEORGIA DOT SPECIFICATIONS SECTIONS 643 AND 894.
- 7. FASTEN FABRIC TO POSTS AT INTERVALS NOT GREATER THAN 14".

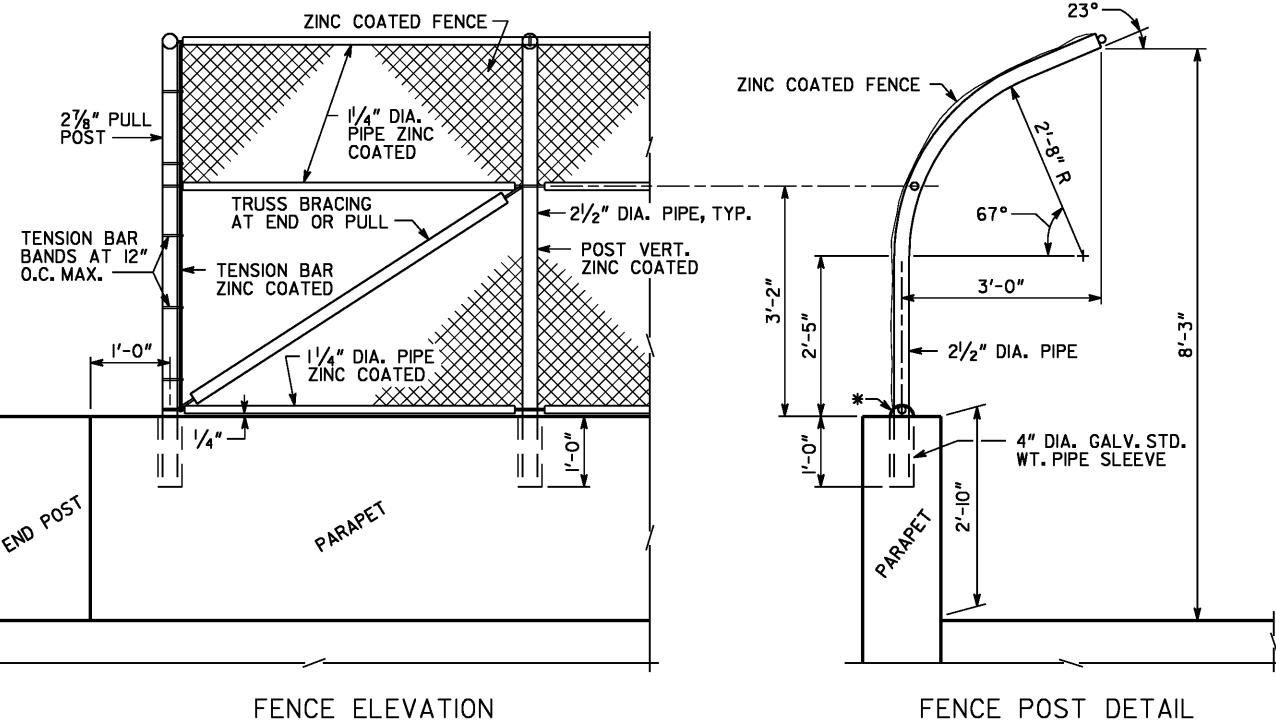

THE LPA GROUP INCORPORATED TRANSPORTATION CONSULTANTS
3595 ENGINEERING DRIVE
NORCHOSS, GEORGIA

GEORGIA

DEPARTMENT OF TRANSPORTATION
ENGINEERING DIVISION-OFFICE OF BRIDGES AND STRUCTURES

MISCELLANEOUS DETAILS
RIDGEWALK PARKWAY OVER I-575
CHEROKEE COUNTY CSNHS-0006-00(043)

DRAWING NO. 35-09 BRIDGE SHEET

LECTION INCH WHEN PRINTED FULL SIZE

9 OF 14

SCALE: NONE

DESIGNED BSB

DRAWN CJH

CHECKED ANZ REVIEWED WEI/WMD
DESIGN GROUP AWB APPROVED PVL

DECEMBER 2010

* NON-SHRINK PORTLAND CEMENT GROUT, TROWEL TO PROVIDE POSITIVE DRAINAGE.

PROJECT NUMBER

GA. | CSNHS-0006-00(043) | 437 | 668

12/11/2012 2:42:56 PM R:\07400004\006043\DGN\As Builts\Structures\09-mi.dgn